




NASSAU STREET

CHAMBERS STREET

- NOTES:**
- EXTERIOR WALLS 8" WIDE
 - HALLWAY WALLS 6" WIDE
 - INTERIOR WALLS 4" WIDE

SQUARE FEET TABULATION

ROOM NO.	SQUARE FEET
401	202
402	300
404 & 405	377
406	238
407	254
408	210
409	222
410 & 411	359
412	234
413	249
416	281
418	229

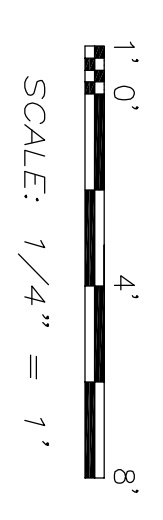

- LEGEND:**
- ALL FINISHED DOORWAY OPENINGS 2'-8" WIDE
 - WINDOW DIMENSIONS FINISHED OPENING
 - ROOM NUMBER
 - RADIATOR

INITIALS	DATE	DESCRIPTION
REVISIONS		
		TEUNISEN SURVEYING & PLANNING CO., INC. RECORDS OF L.T. CHURCH, GENERAL CORP. OF AMERSONIZATION, INC., 4770222 LENOX, GRANT H. LENOX 319 SOUTH AVENUE, FANWOOD, NEW JERSEY 07023 TELEPHONE: (908) 233-3550 FACSIMILE: (908) 233-3409
		"AS BUILT" SURVEY OF FOURTH FLOOR OF TWENTY NASSAU STREET PROFESSIONAL BUILDING SITUATED IN THE BOROUGH OF PRINCETON, MERCER COUNTY, N.J.
		EDWARD R. TEUNISEN NEW JERSEY PROFESSIONAL LAND SURVEYOR No. 21146 PENNSYLVANIA PROFESSIONAL LAND SURVEYOR No. 022324-E NEW JERSEY PROFESSIONAL PLANNER No. 018932 DATE: _____ SCALE: 1/4" = 1' TSP. No. 6
		D.H. E.R.T. _____ DATE: _____ SCALE: 1/4" = 1' TSP. No. 7